


AS CONSTRUCTED

PEN COUNT

- 12m PENS= 11
- 13m PENS= 1
- 14m PENS= 1
- 15m PENS= 1

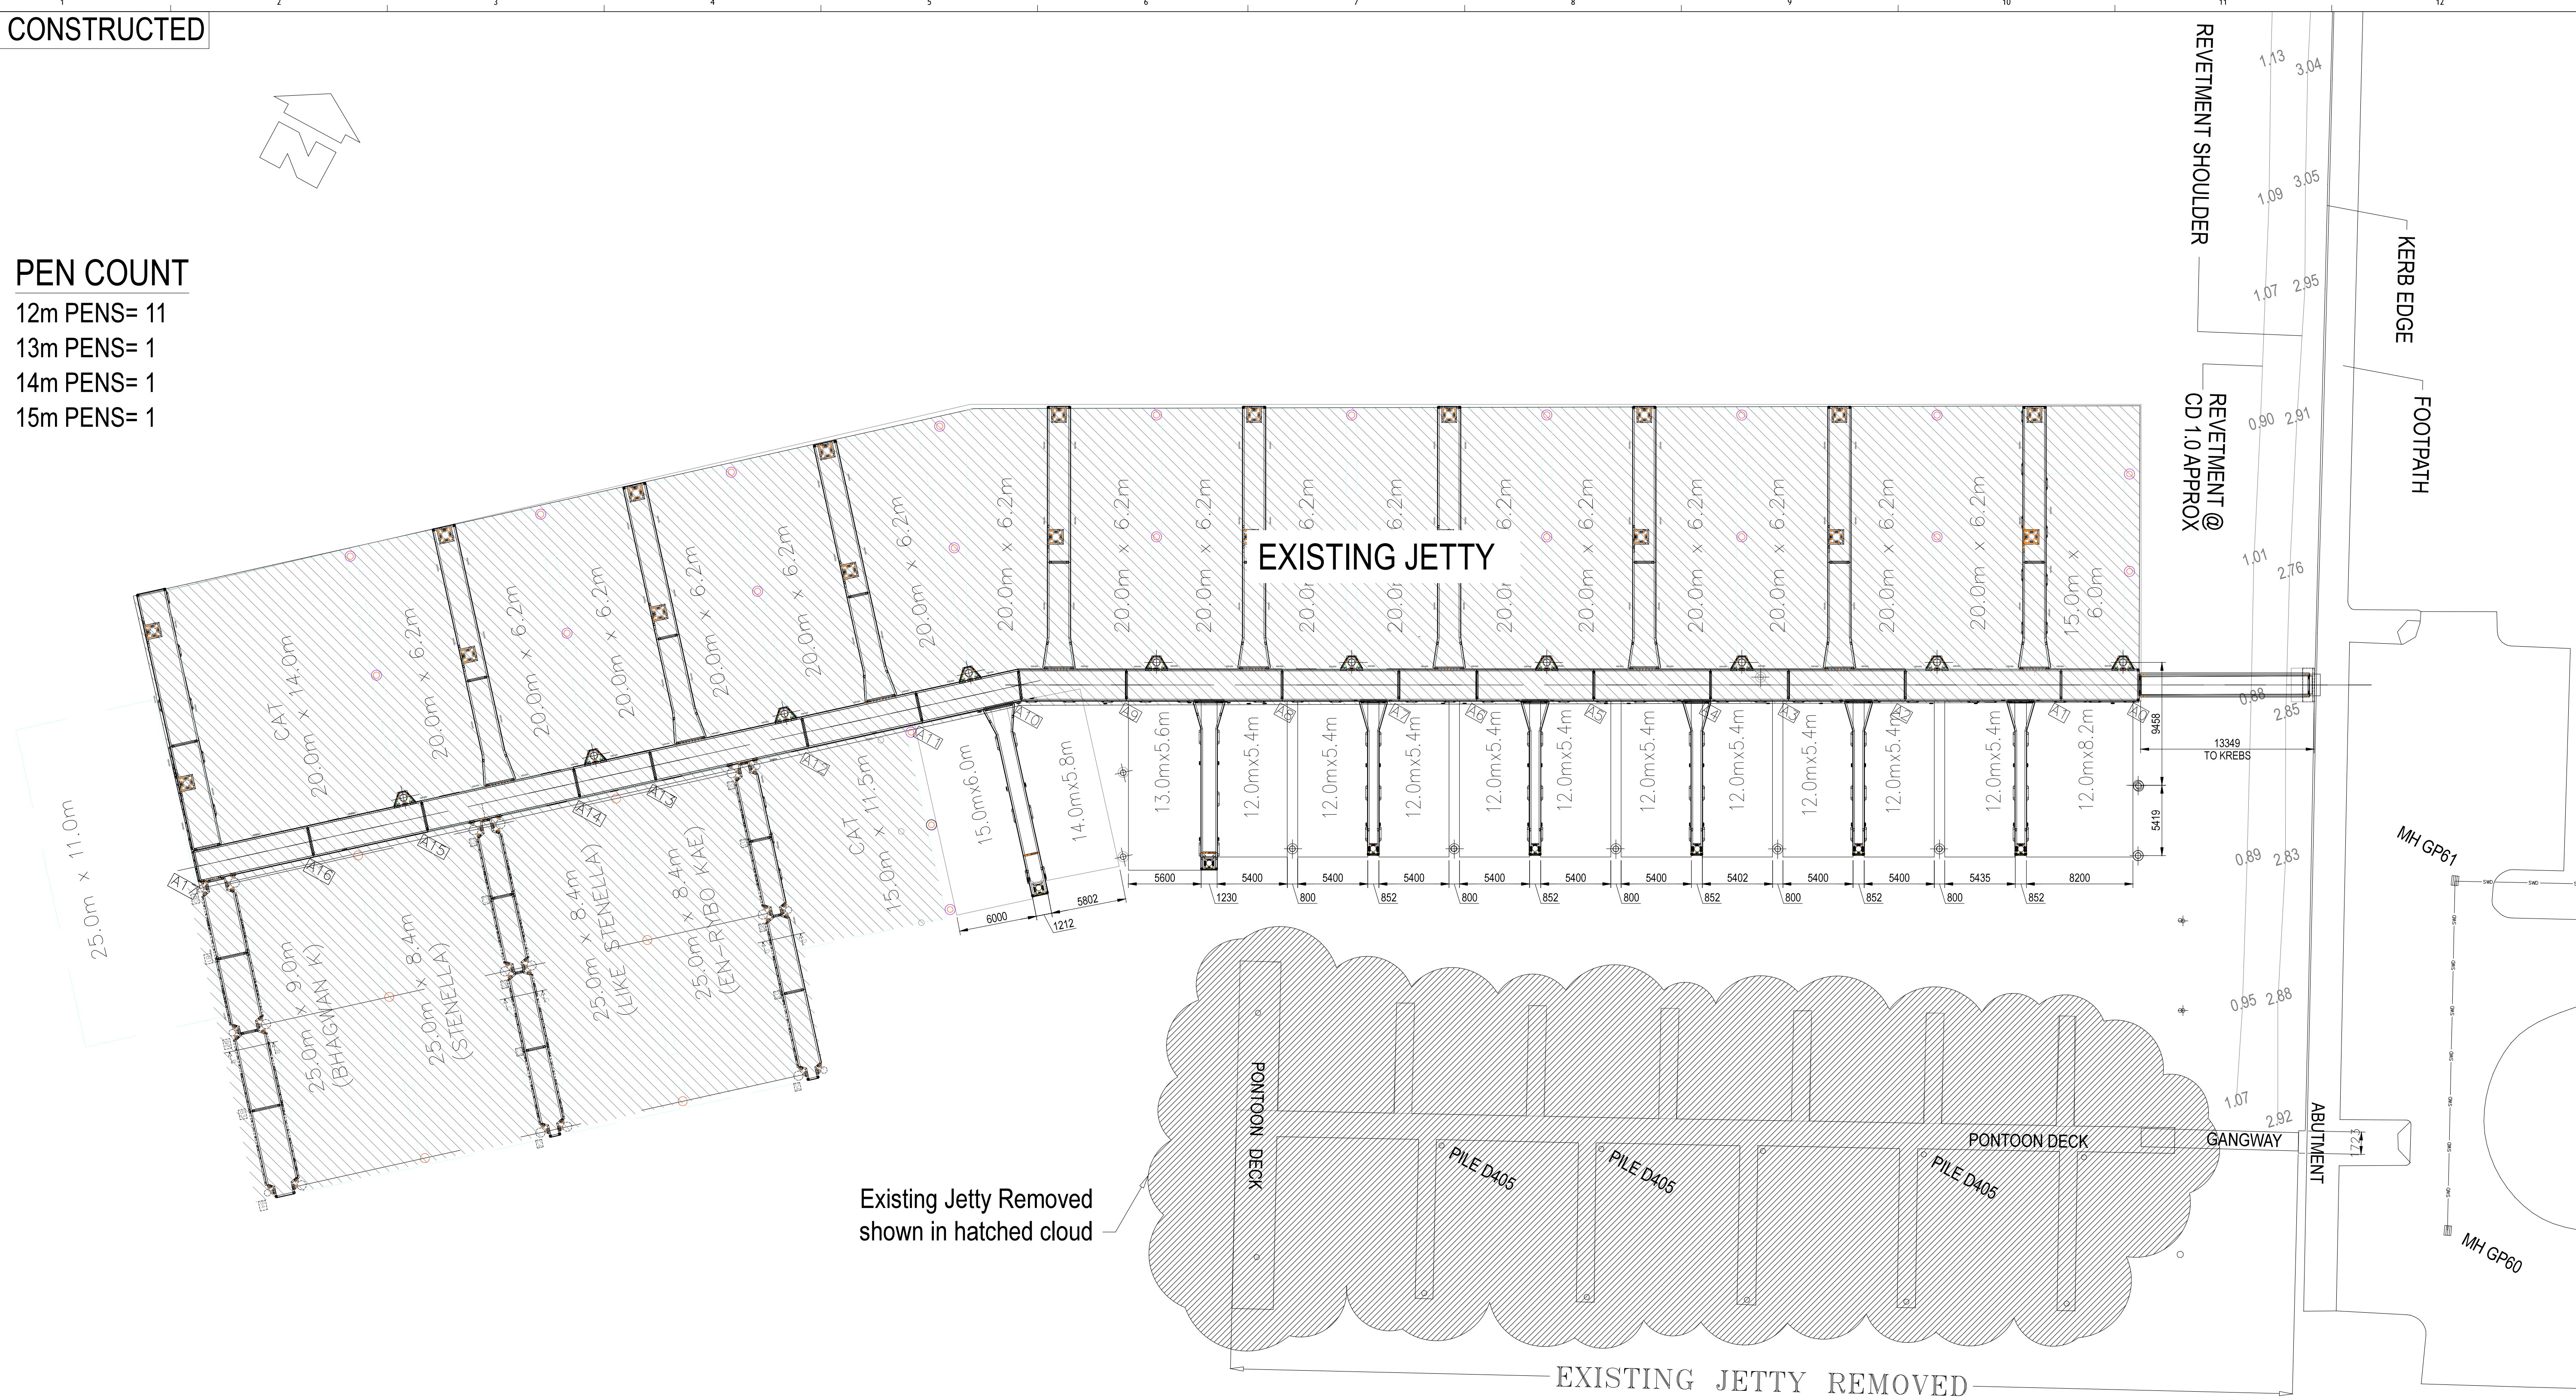

GENERAL LAYOUT
SCALE 1:250

DATUM COMPARISON	
SOUNDING	A.H.D.
HAT 2.89	HAT 1.49
MHWS 2.35	MHWS 0.95
MHWN 1.74	MHWN 0.343
MSL 1.47	MSL 0.07
1.40	0.000
MLWN 1.20	MLWN -0.20
MLWS 0.58	MLWS -0.82
LAT 0.02	LAT -1.38

-		-		SCALE: 1:250		UNLESS OTHERWISE STATED DIMENSIONS IN MILLIMETRE		DESIGN CONSULTANT:		CONTRACTOR:		Department of Transport	
4	30.08.2016	AS CONSTRUCTED	P.R.	METADATA:						PROJECT MANAGER PROJECT DIRECTOR DIRECTOR OF PROJECT DELIVERY		EXMOUTH BOAT HARBOUR	
3	27.07.2016	ISSUED FOR CONSTRUCTION	P.R.	HORIZ DATUM: EXM 94								CONSTRUCTION OF FLOATING PENS-JETTY B STAGE2	
2	19.07.2016	ISSUED FOR CONSTRUCTION	P.R.	VERT. DATUM: CHART DATUM WHICH IS 12 796m BELOW DMH 052 AND 14.0m BELOW AHD								GENERAL LAYOUT	
1	15.06.2016	ISSUED FOR CONSTRUCTION	P.R.	AERIAL PHOTOGRAPHY: -								DRAWING NUMBER 1775 - 02 - 01	
ORIG SIZE A1		FILE No		AMENDMENT		DRN		DESIGN APPROVAL		CROWN COPYRIGHT		REVN 4	