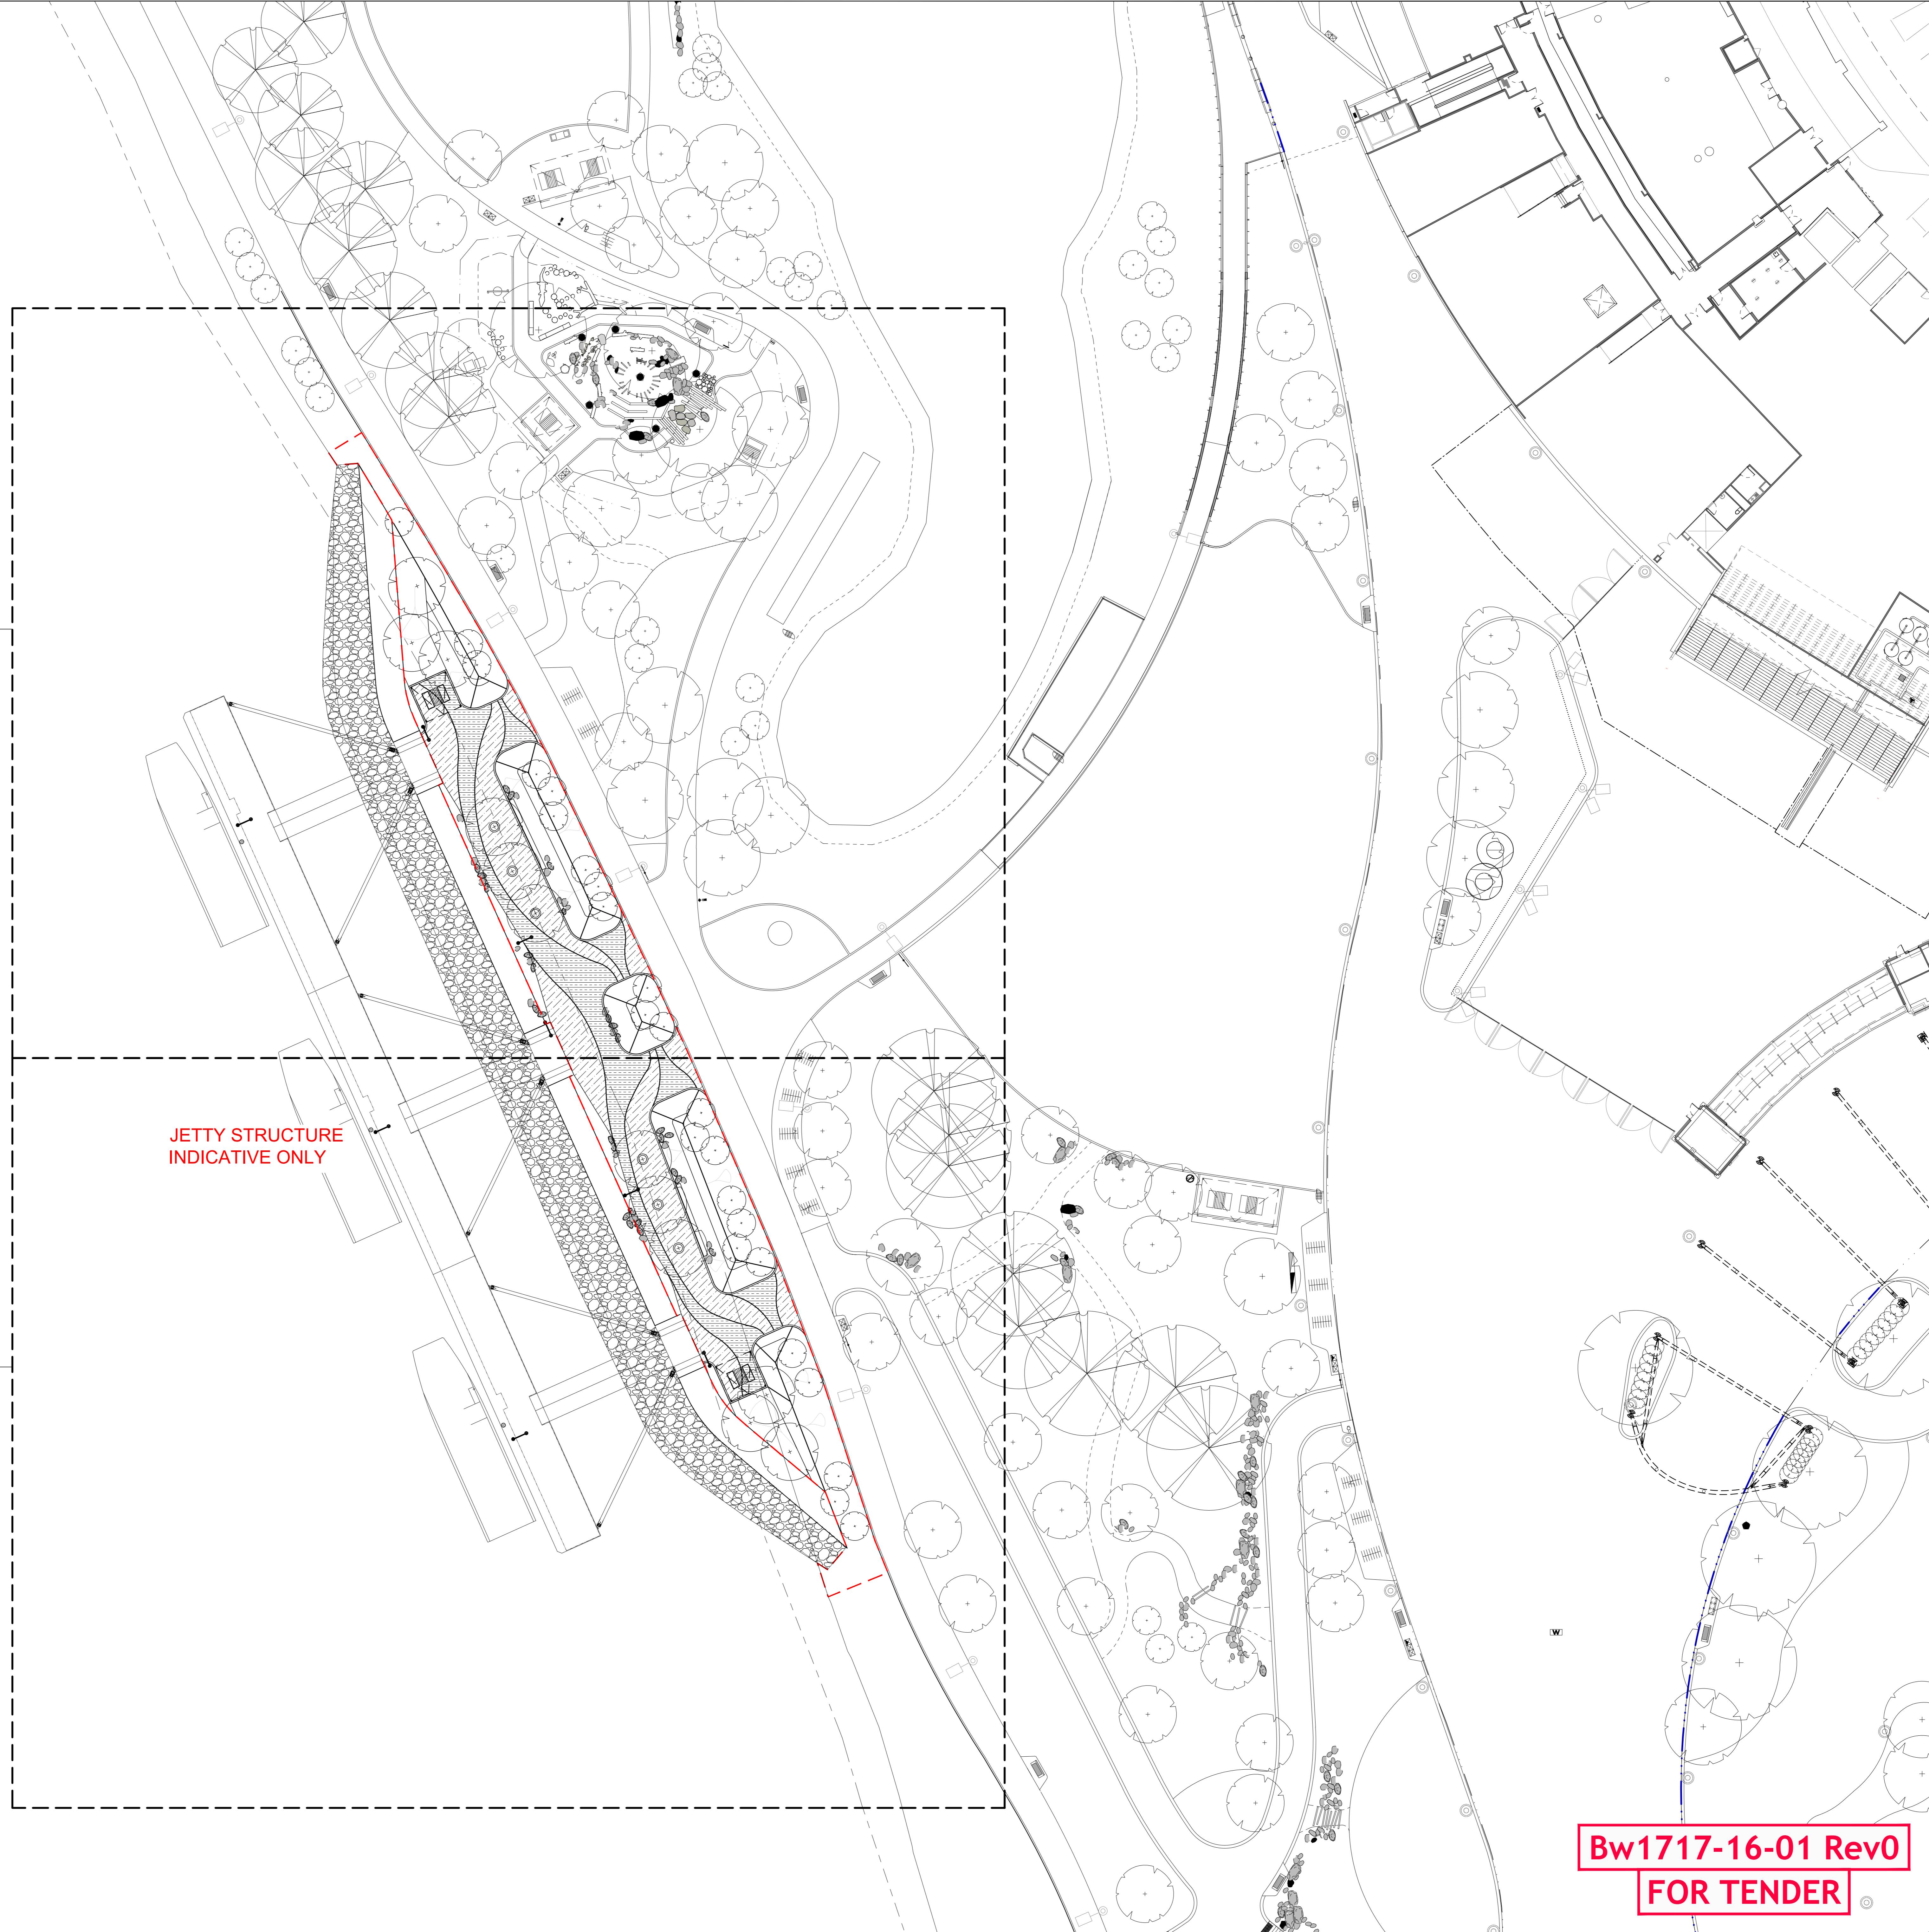


BURSWOOD PUBLIC JETTY

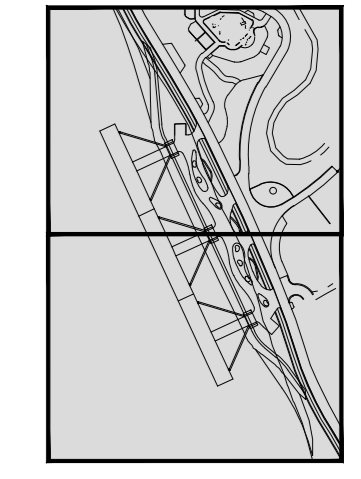
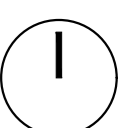


SEE DRAWINGS:
 L0100 GENERAL ARRANGEMENT AND FINISHES PLAN
 L0200 GRADING AND PLANTING PLAN

SEE DRAWINGS:
 L0101 GENERAL ARRANGEMENT AND FINISHES PLAN
 L0201 GRADING AND PLANTING PLAN

JETTY STRUCTURE
 INDICATIVE ONLY

Bw1717-16-01 Rev0
FOR TENDER

REFERENCE MAP  NORTH 

NOTES
 1. DO NOT SCALE DRAWINGS. WRITTEN DIMENSIONS GOVERN.
 2. ALL DIMENSIONS ARE IN MILLIMETRES UNLESS NOTED OTHERWISE.
 3. ALL DIMENSIONS SHALL BE VERIFIED ON SITE BEFORE PROCEEDING WITH THE WORK. HASSELL SHALL BE NOTIFIED IN WRITING OF ANY DISCREPANCIES.
 4. THIS DRAWING MUST BE READ IN CONJUNCTION WITH ALL RELEVANT CONTRACTS, SPECIFICATIONS AND DRAWINGS.

© COPYRIGHT OF THIS DRAWING IS VESTED IN HASSELL. LTD.
 2017 HASSELL LTD.
 THIS DRAWING IS AN UNCONTROLLED COPY UNLESS NOTED OTHERWISE.

ISSUED FOR TENDER
 (RED MARKUPS BY DoT) 14.06.17

| REV | DESCRIPTION | DATE |
|-----|-----------------|----------|
| 0 | FOR INFORMATION | 24.04.17 |
| B | FOR INFORMATION | 30.03.17 |
| A | FOR INFORMATION | |

CONSULTANT
 HASSELL LIMITED ACN 007 711 435
 PODIUM LEVEL CENTRAL PARK
 150-158 ST GEORGES TERRACE
 PERTH WA 6000 AUSTRALIA
 PERTH@HASSELLSTUDIO.COM
 T 61 8 6477 6000

HASSELL

PROJECT
 BURSWOOD PUBLIC JETTY

DRAWING TITLE
 Cover Page

STATUS
 FOR INFORMATION

| SCALE @ A0 | DRAWN | CO-ORD | REVIEWED | APPROVED |
|------------|-------|--------|----------|----------|
| 1:250 | ST | HG | HG | AB |

| PROJECT NUMBER | DRAWING NUMBER | REV |
|----------------|----------------|-----|
| 012423 | L0001 | 0 |

FILENAME: G:\RevDev\Bw\Files\Working\Bw\Bw1717-16-01_01\Bw1717-16-01_01.dwg